

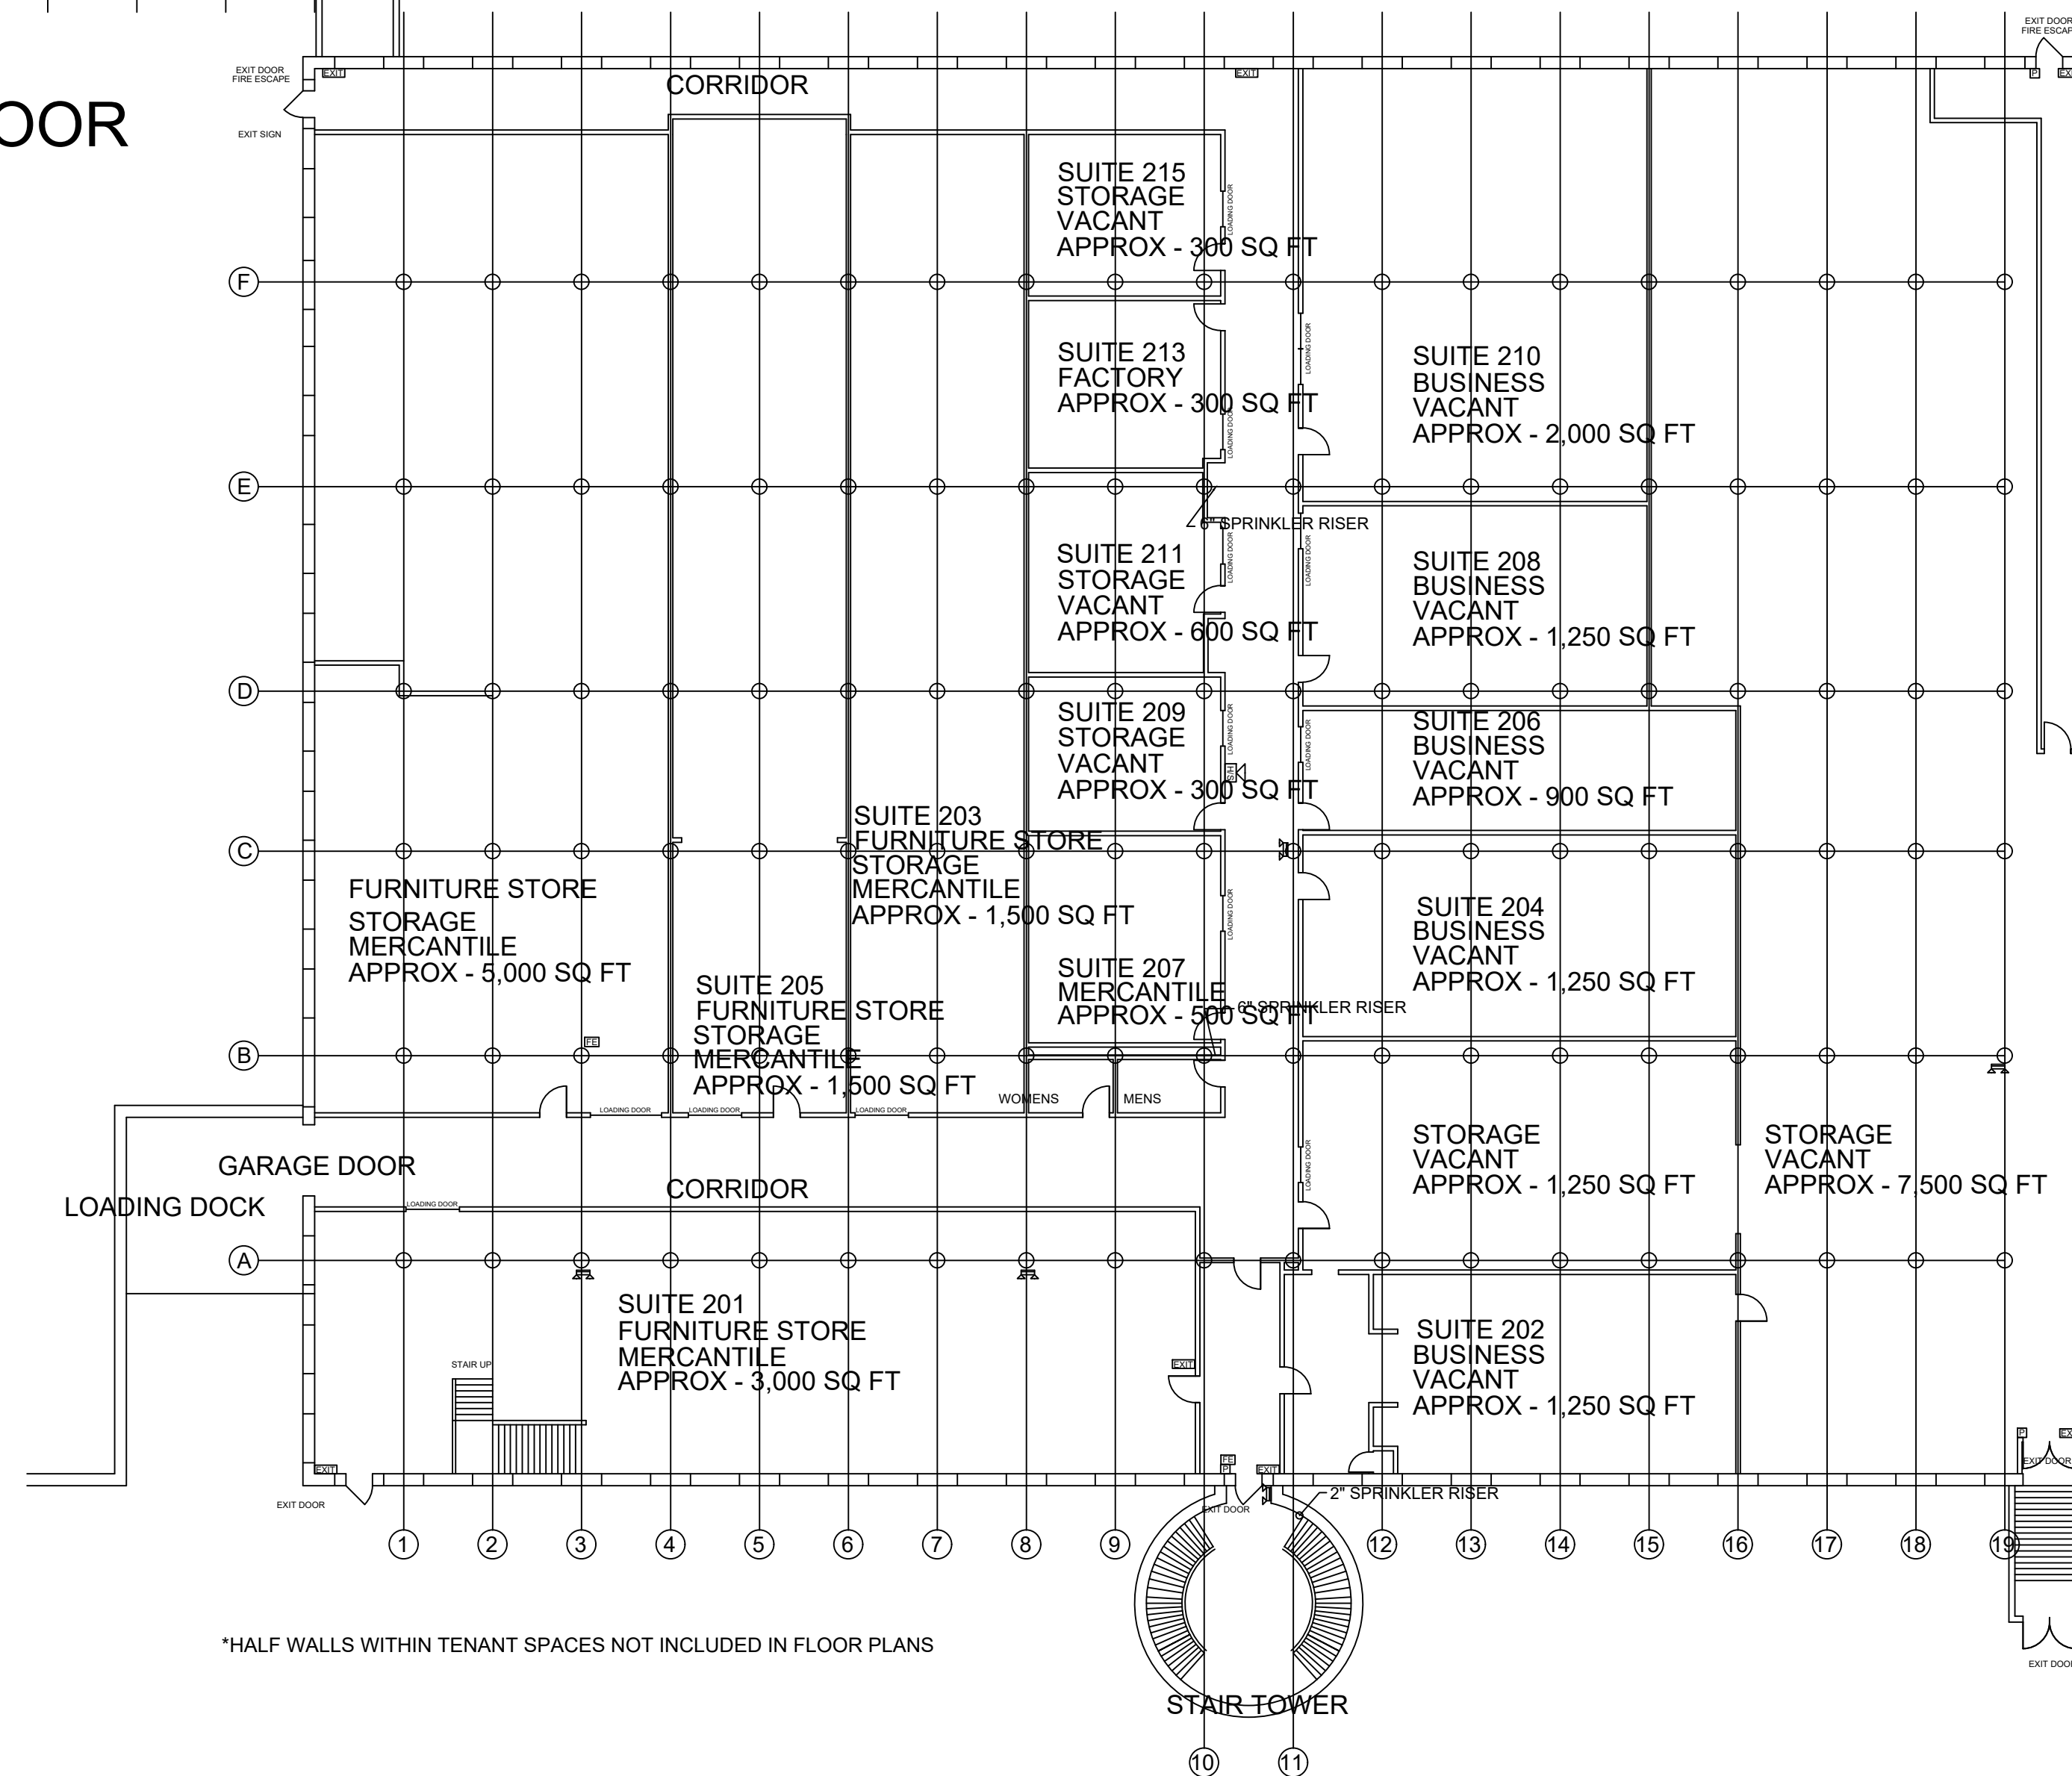


BUILDING 8 - 2ND FLOOR

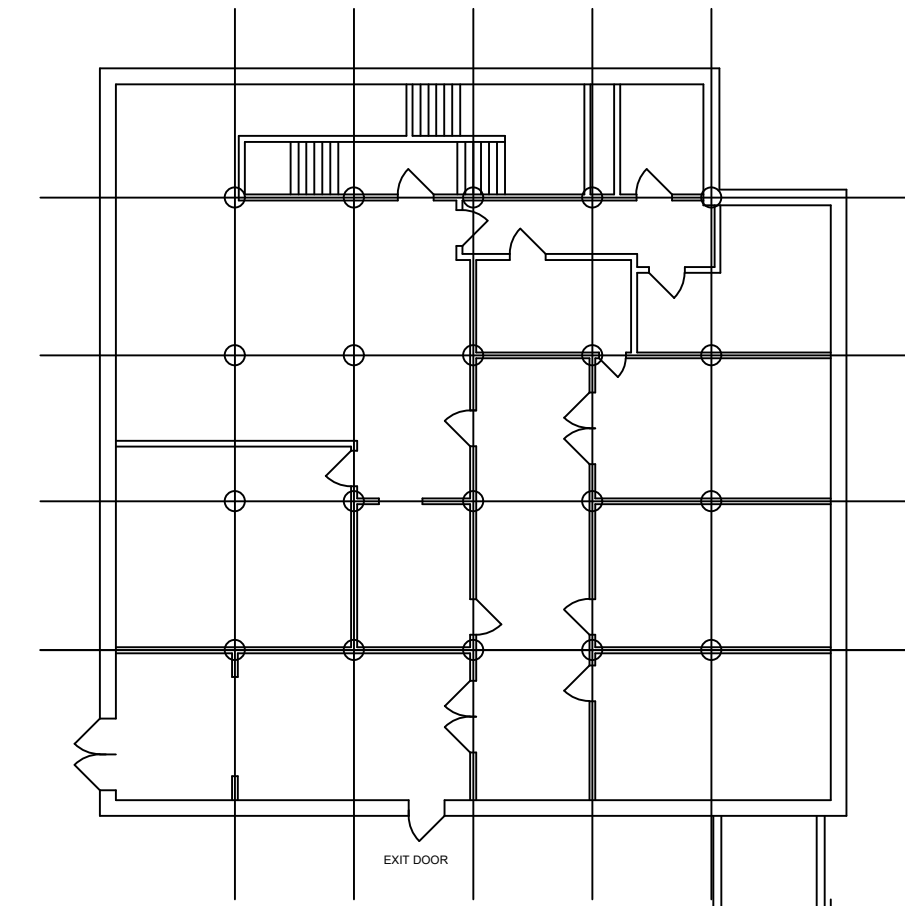


BUILDING 2 - 2ND FLOOR

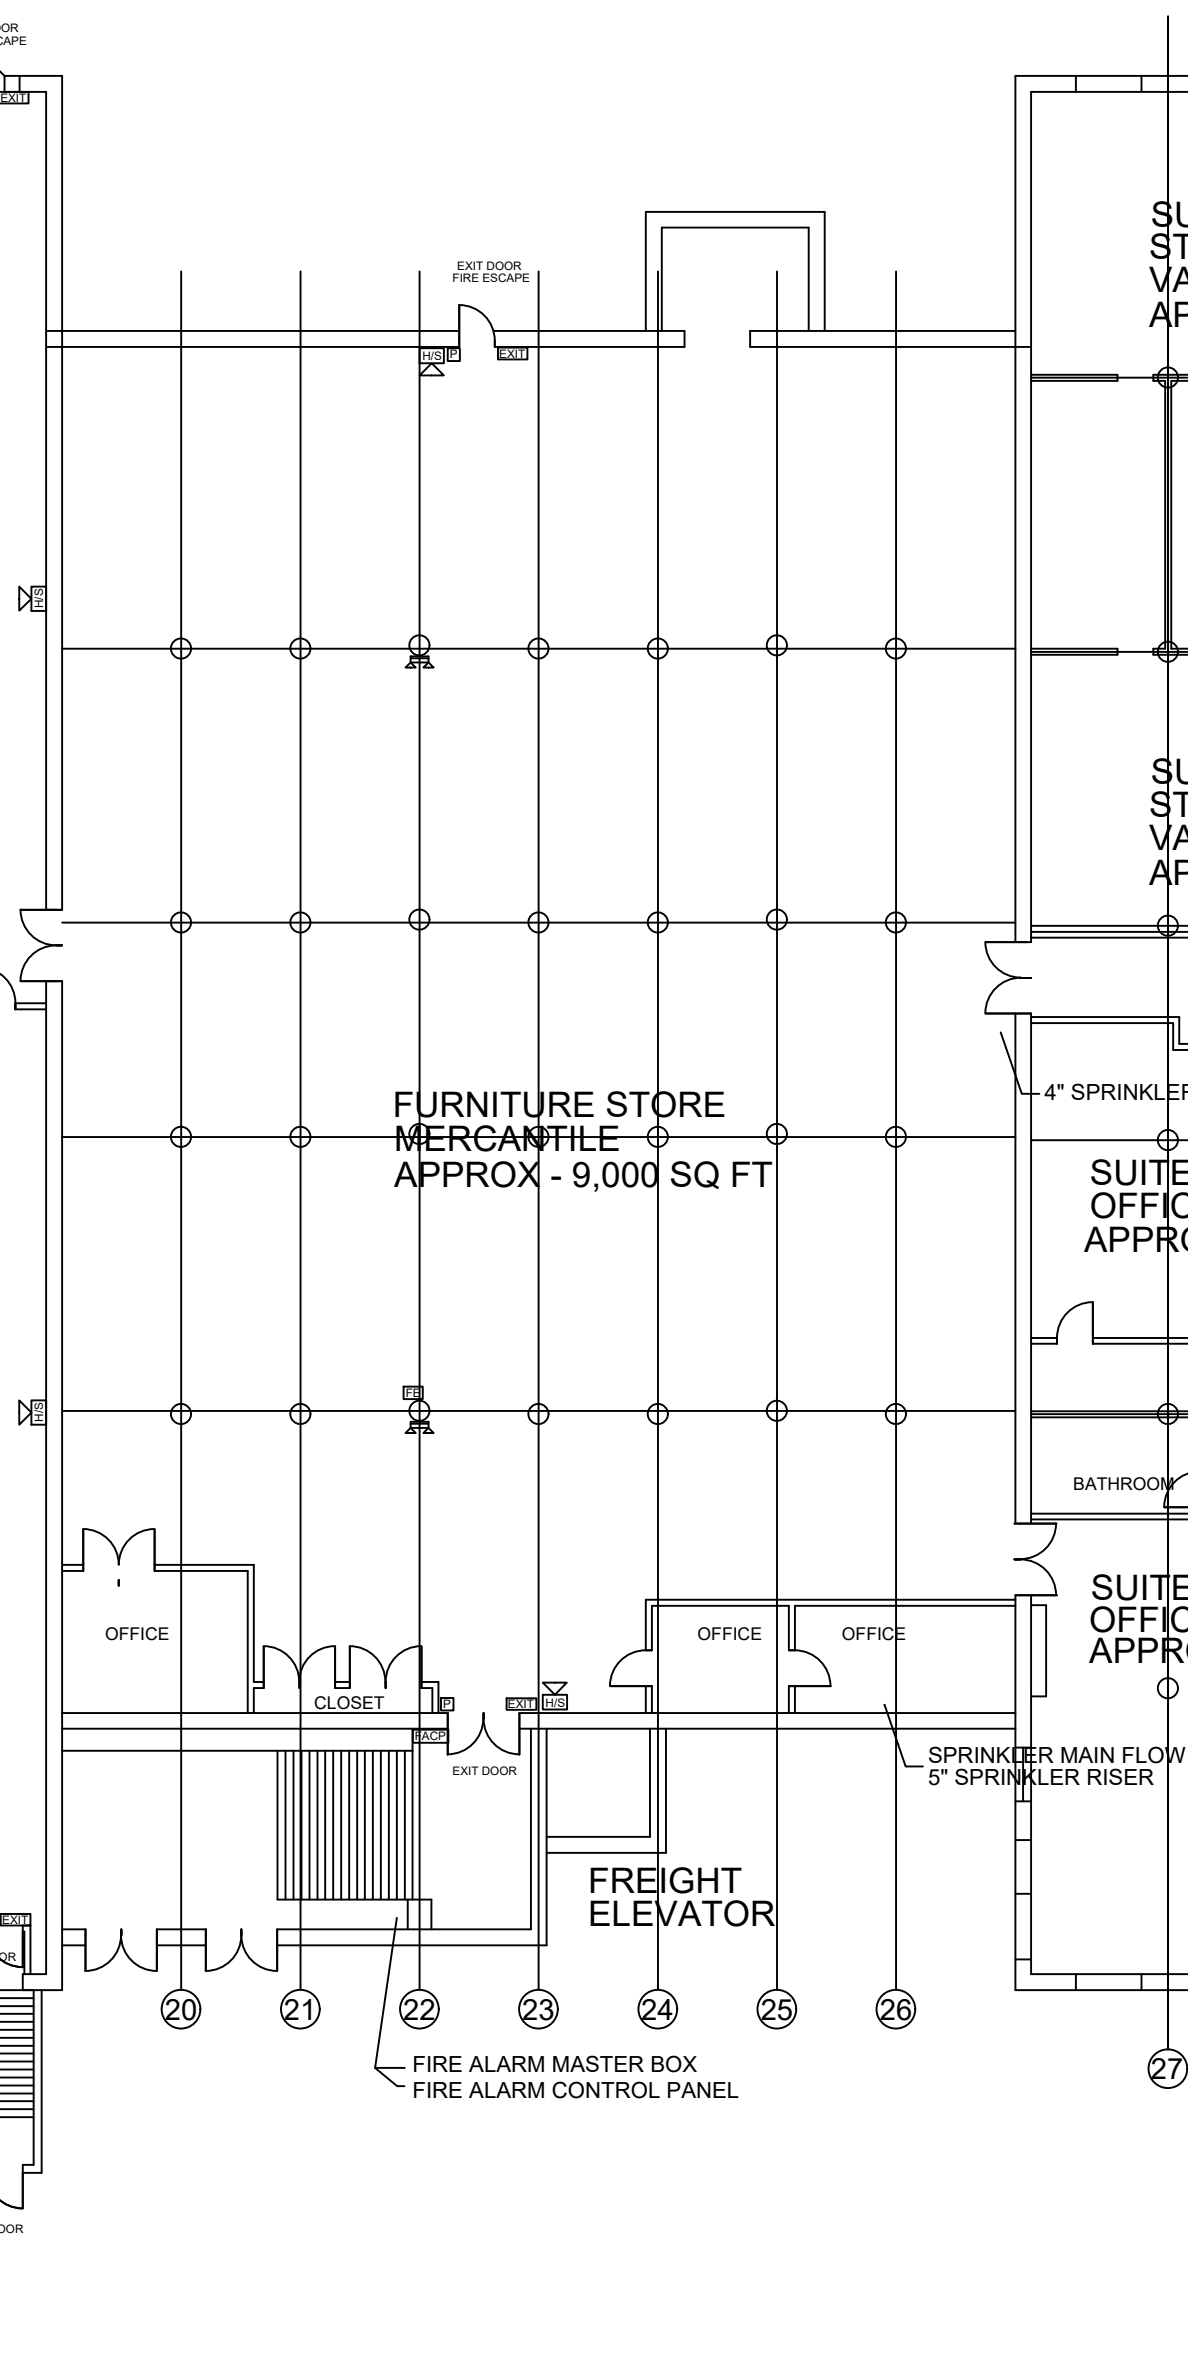

BUILDING 2 1/2 - 2ND FLOOR

PERMIT ISSUED FOR NEW
144" WIDE x 108" HIGH OPENING
BETWEEN UNITS 622 AND 624

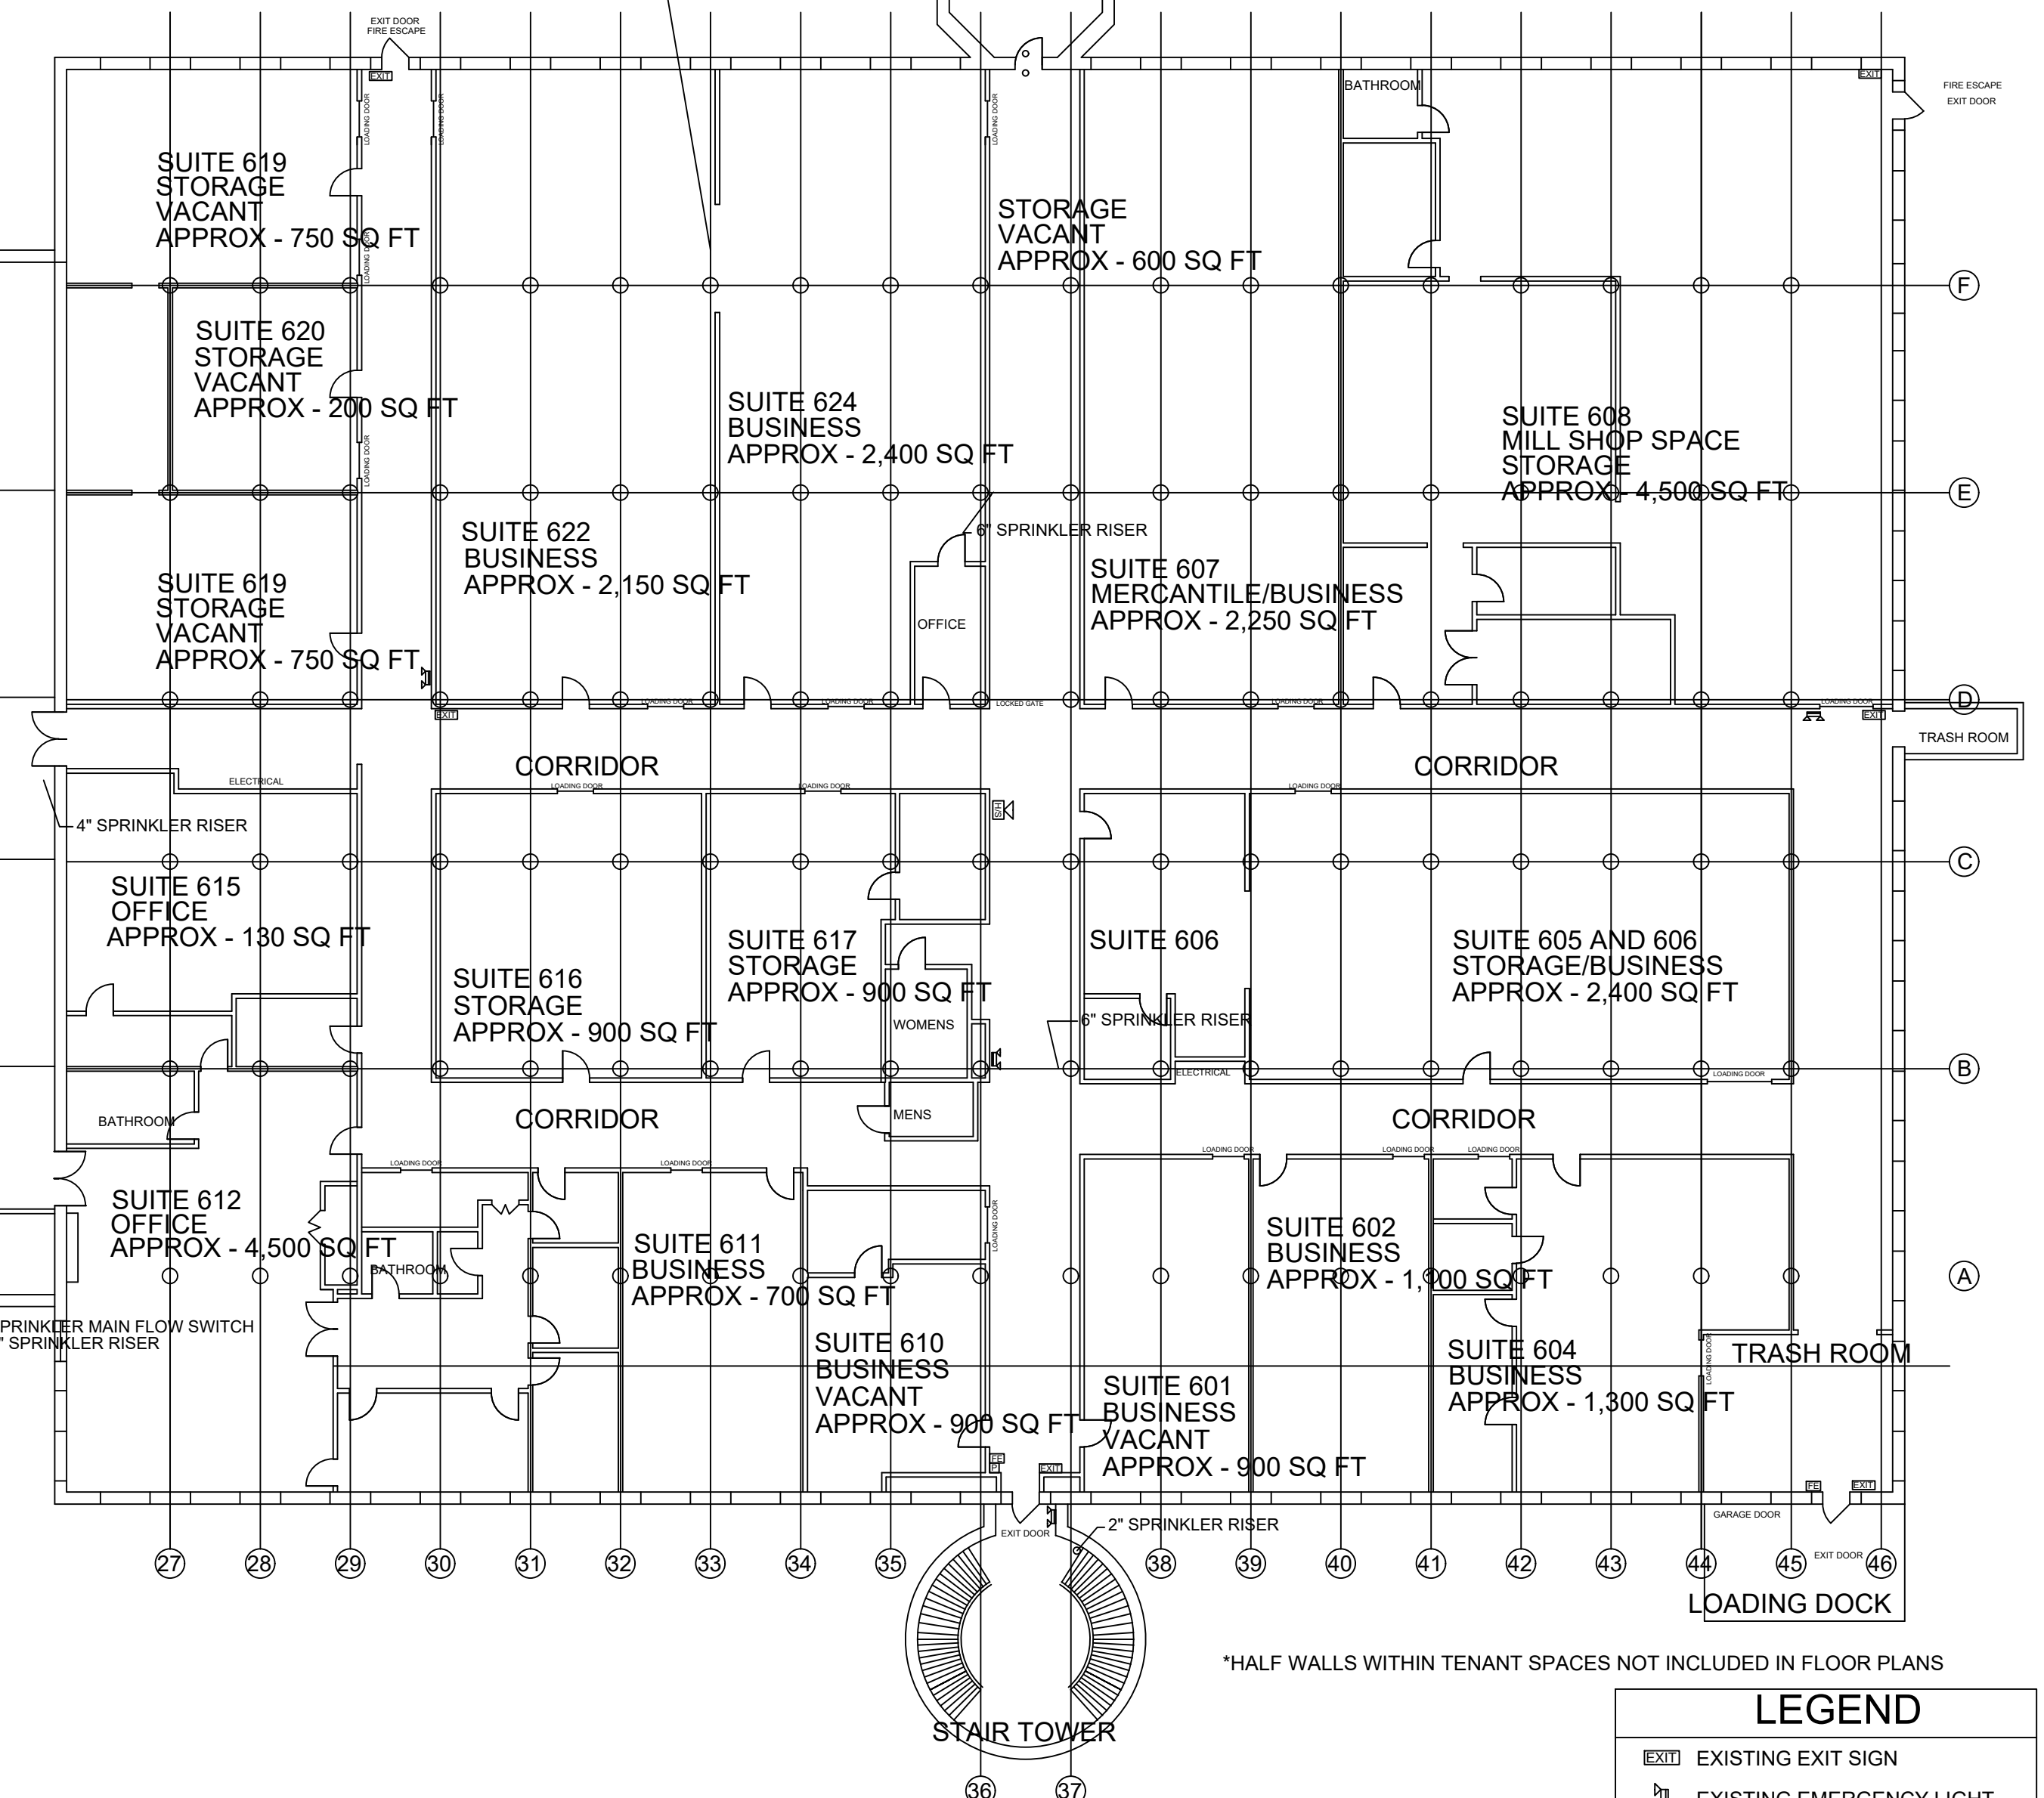

BUILDING 3 - 2ND FLOOR

LEGEND

	EXISTING EXIT SIGN
	EXISTING EMERGENCY LIGHT
	EXISTING FIRE EXTINGUISHER
	EXISTING PULL STATION
	EXISTING HORN/STROBE

SCALE - 1/16" = 1'-0"