

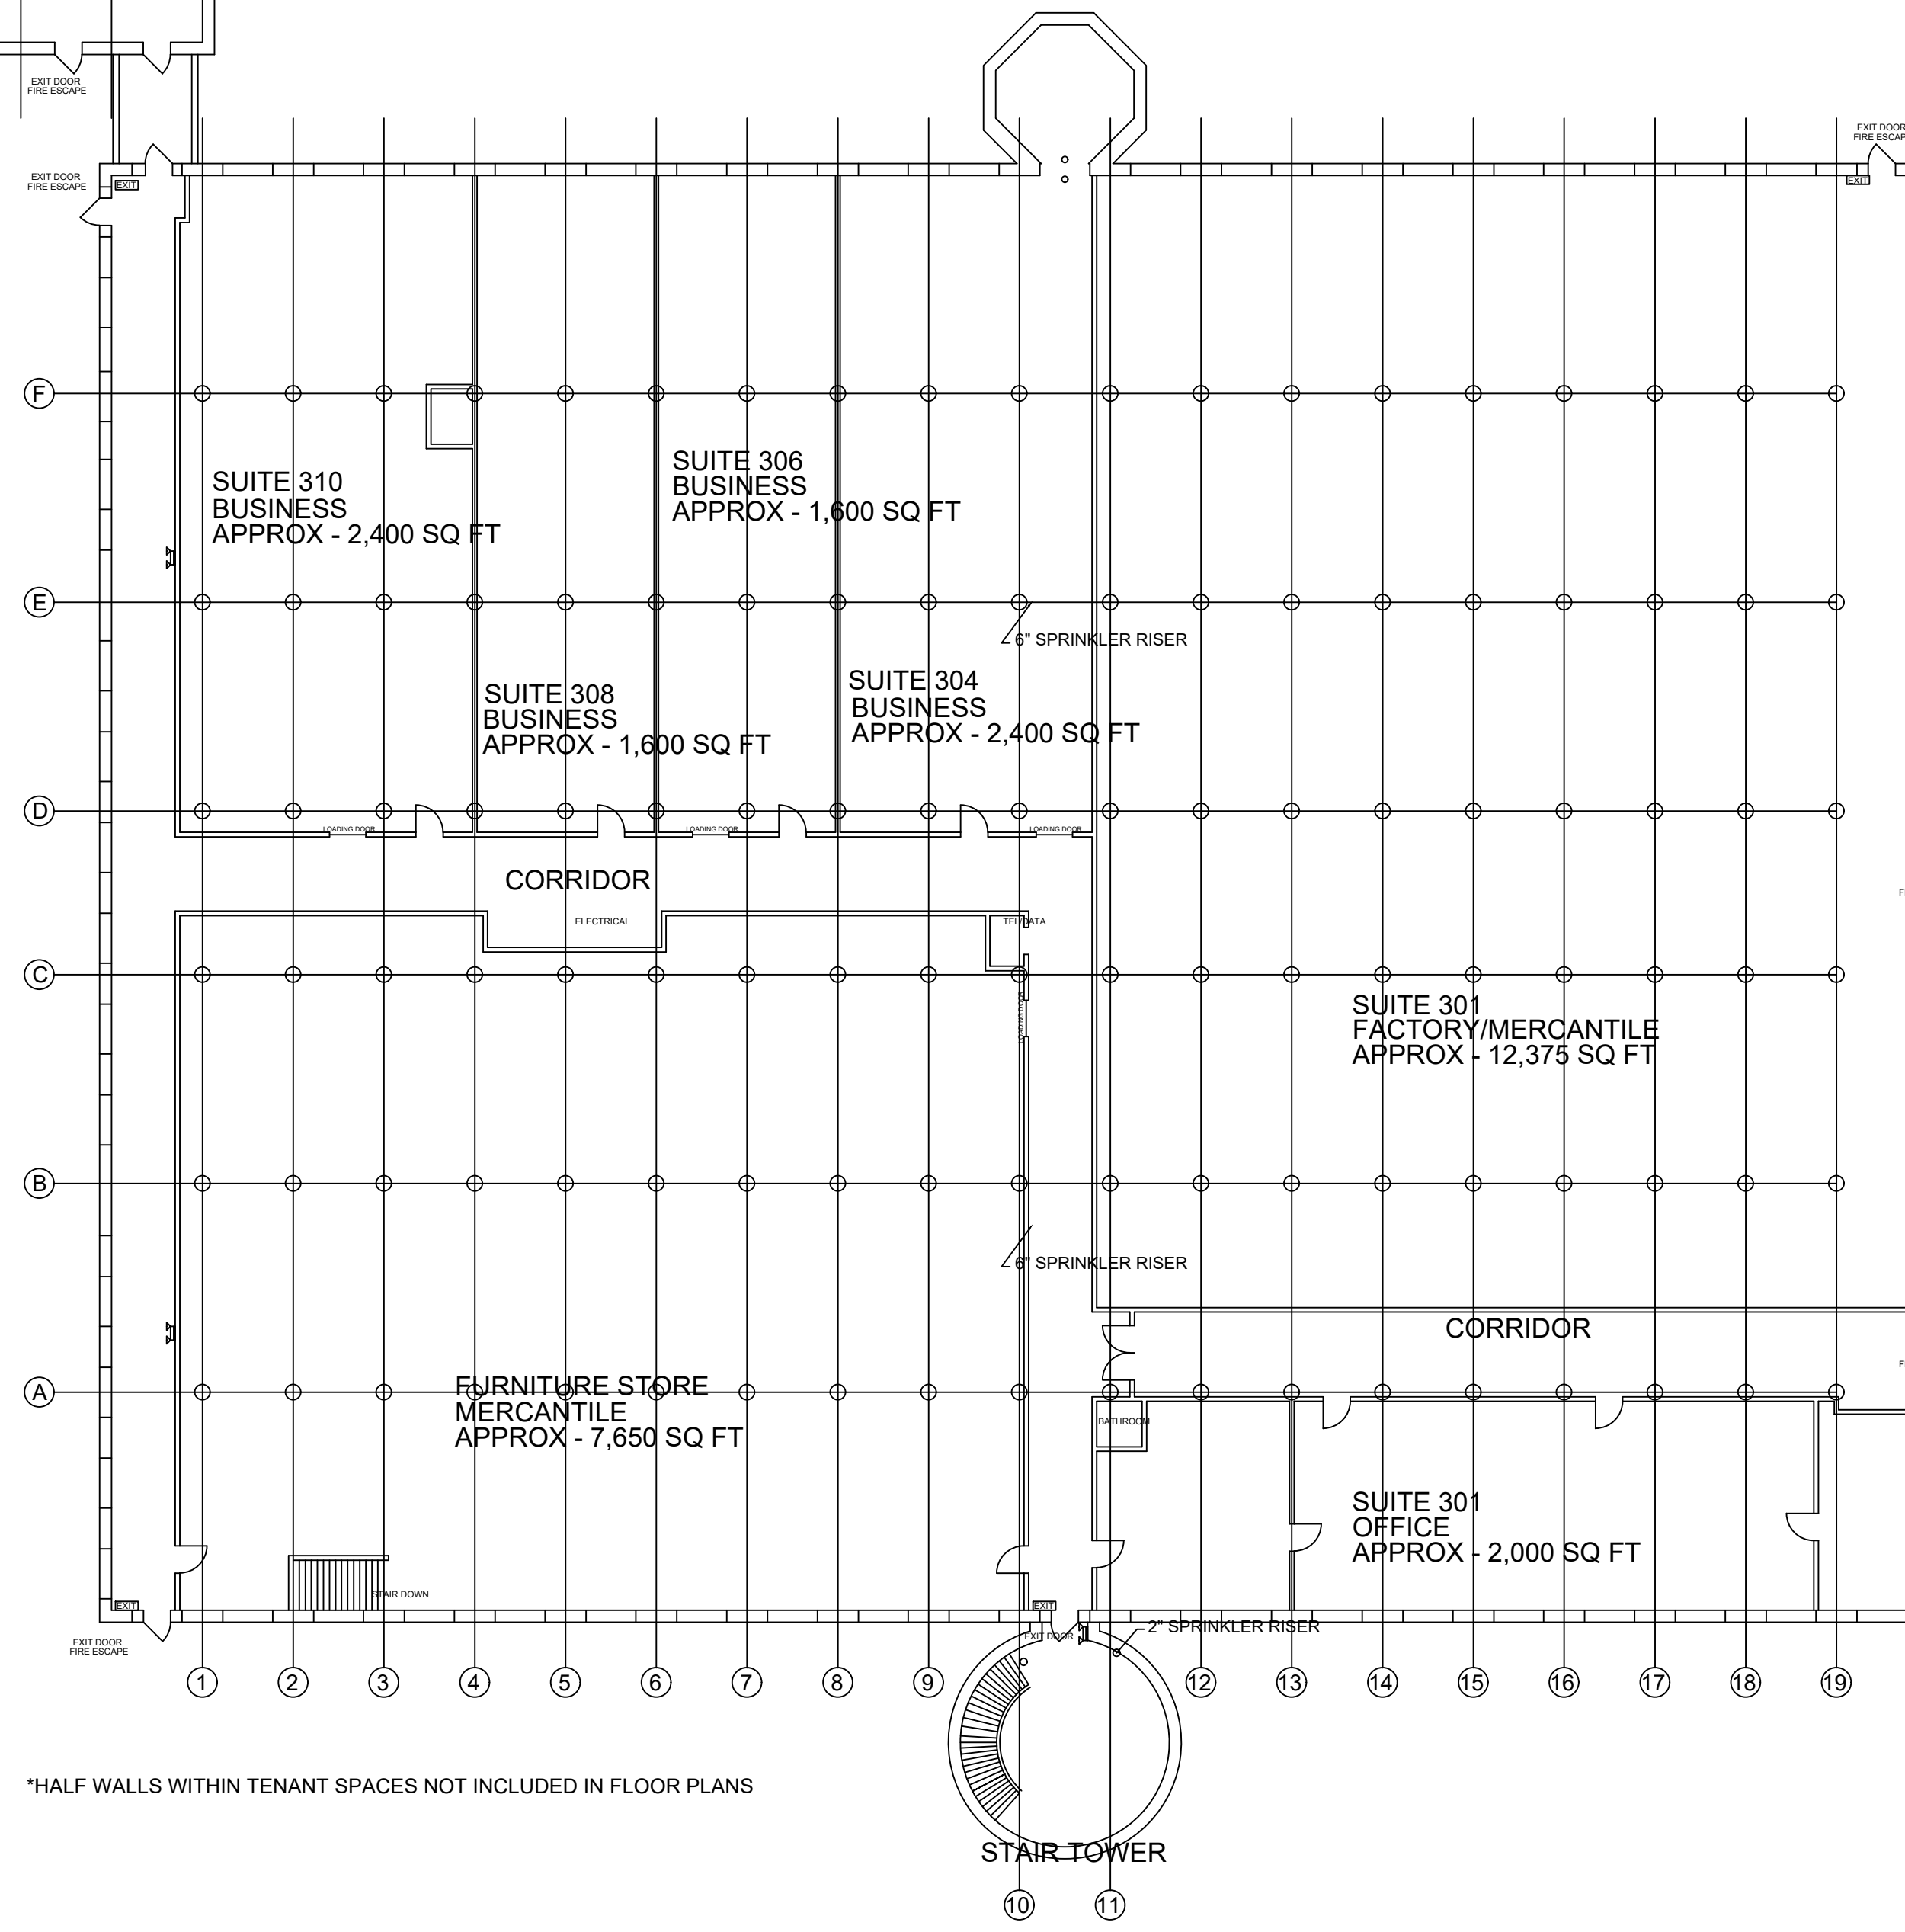



BUILDING 8 - 3RD FLOOR

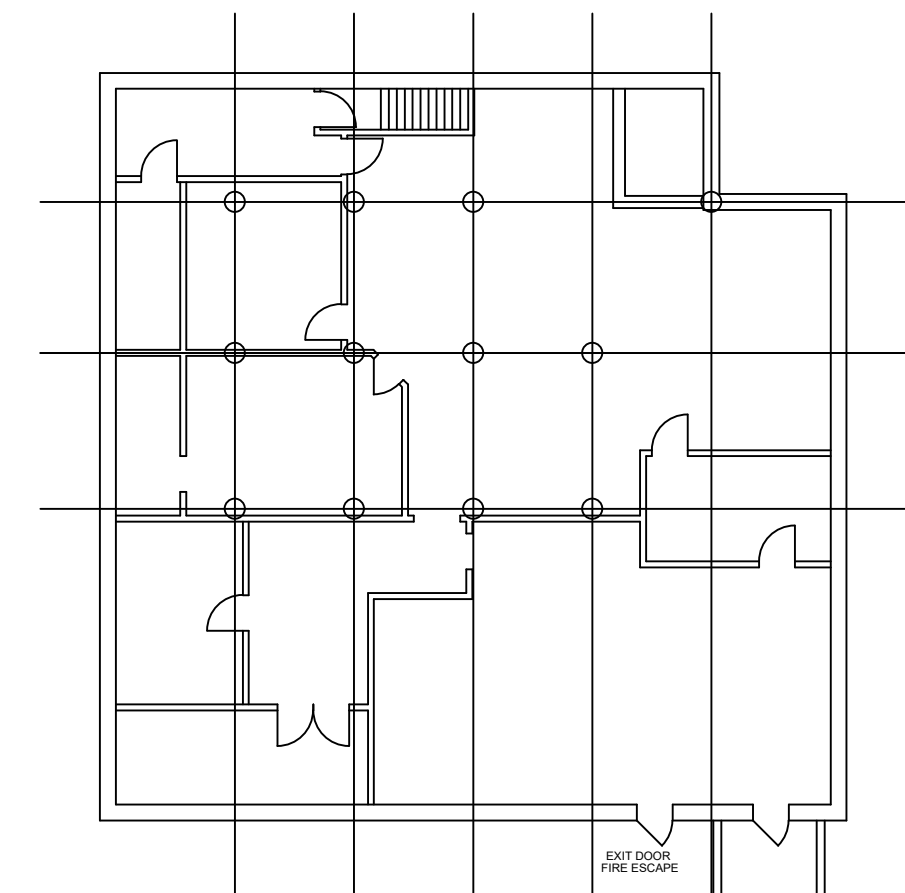

BUILDING 2 - 3RD FLOOR

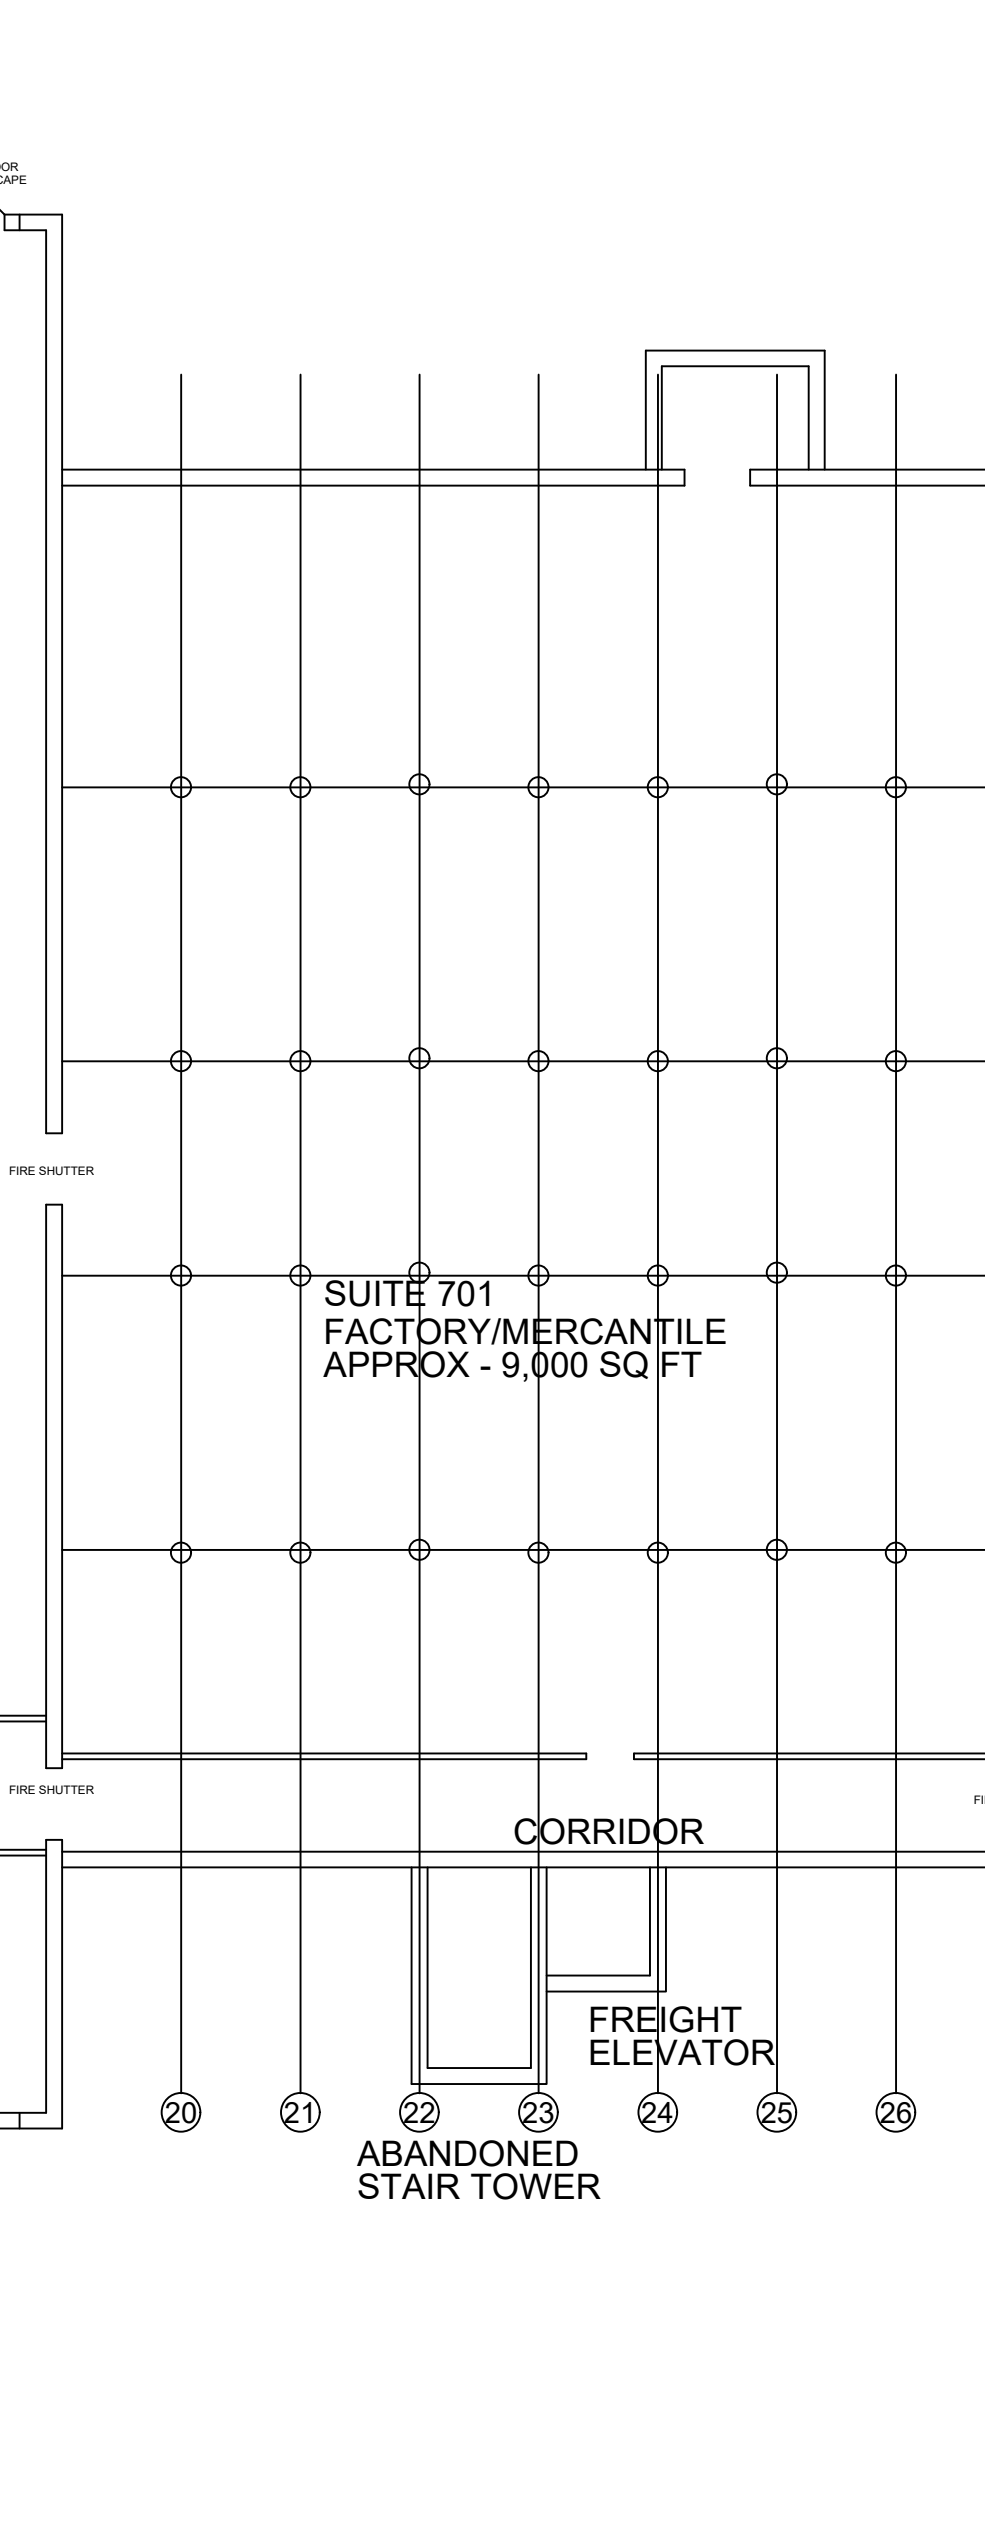

BUILDING 2 1/2 - 3RD FLOOR

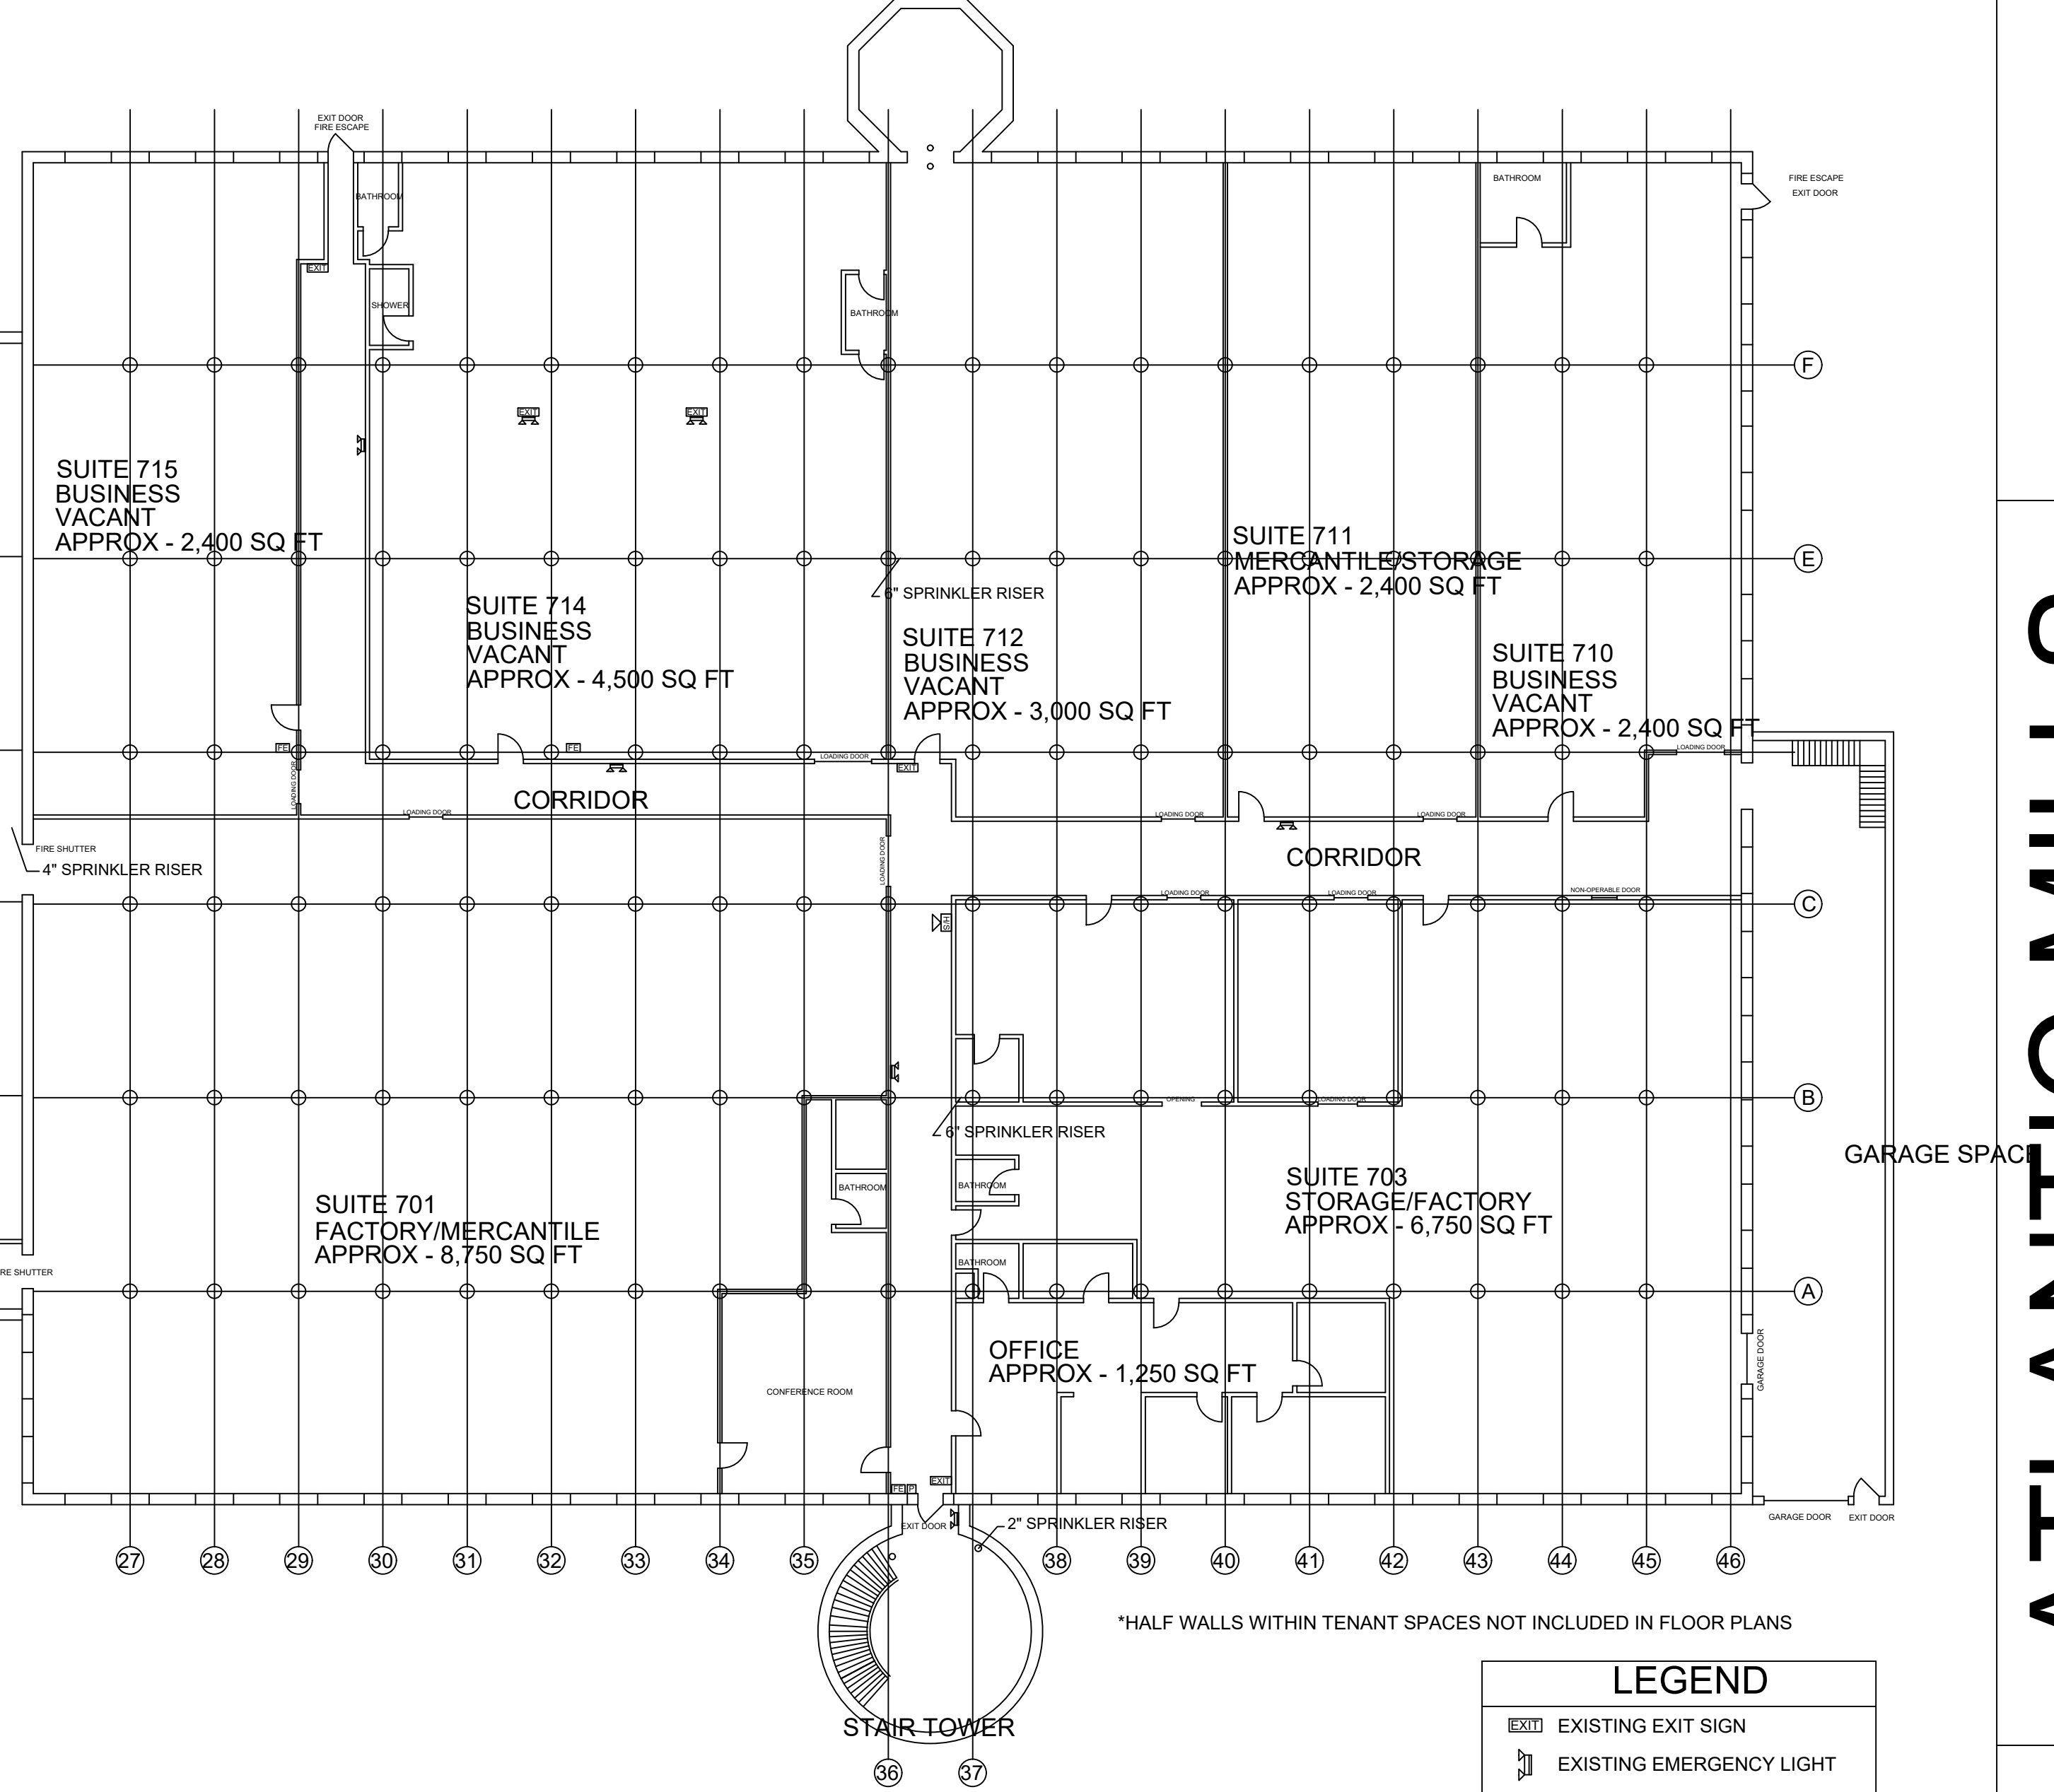

BUILDING 3 - 3RD FLOOR

*HALF WALLS WITHIN TENANT SPACES NOT INCLUDED IN FLOOR PLANS

*HALF WALLS WITHIN TENANT SPACES NOT INCLUDED IN FLOOR PLANS

LEGEND	
	EXISTING EXIT SIGN
	EXISTING EMERGENCY LIGHT
	EXISTING FIRE EXTINGUISHER
	EXISTING PULL STATION
	EXISTING HORN/STROBE

SCALE - 1/16" = 1'-0"

GARAGE SPACE